PIANTA PIANO RIALZATO _ ARREDI AS BUILT
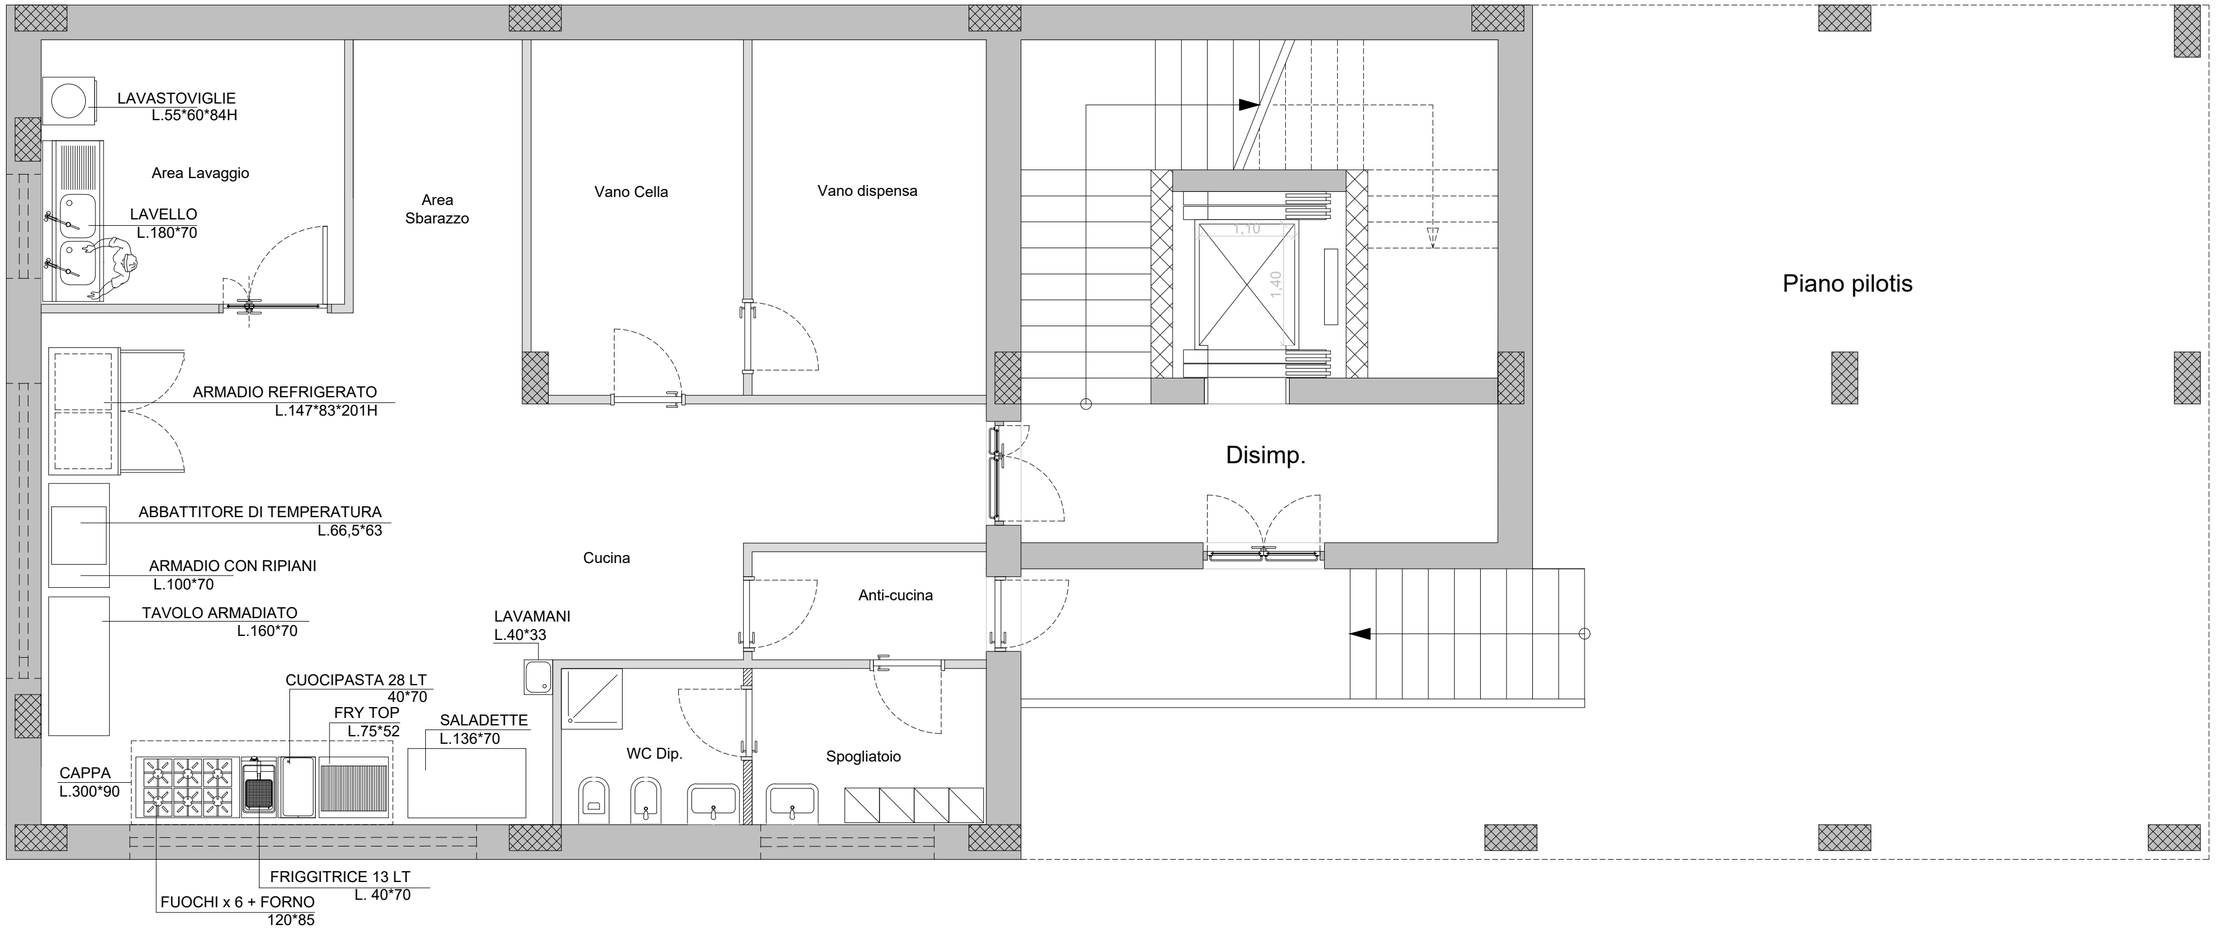
Scala 1:50